


MAIN FLOOR

GARAGE WALL 2'
REMOVE MASTER DOOR
SHIFT BREAKFAST WALL TO RIGHT 2'
MASTER WIC & DOORS
MASTER BED → BATH DOOR POCKET DOOR
WINDOW IN MASTER SHOWER
DINING NO DOOR ADD SAME WINDOW
BREAKFAST → 2 DOORS AS SHOWN
FRONT DOOR = 6'
STAIRS UP DIRECTLY ABOVE DOWN
GARAGE DOORS 10x8, 10x8
NEW GARAGE = ONE DOUBLE DOOR
DOUBLE GARAGE ADDED WATER HEATER
WATER SOFTENER
BOTTLER
NO DOOR IN BEDROOM 2 CLOSET

BASEMENT

NO BASEMENT WALKOUT (& DOORS / WINDOWS)
NO DOORS TO WIC #5 / #6
36" BEDROOM DOORS #5 / #6
4 ~~ENTRANCES~~ ~~WIT~~ DOORS
DOOR TO THEATER ~ 36" DOOR
MECH / STORAGE NEW WALL - 36" DOOR
MAKE BEDROOMS SAME ~~SIZE~~ SQUARE FEET

1 GROUND FLOOR PLAN

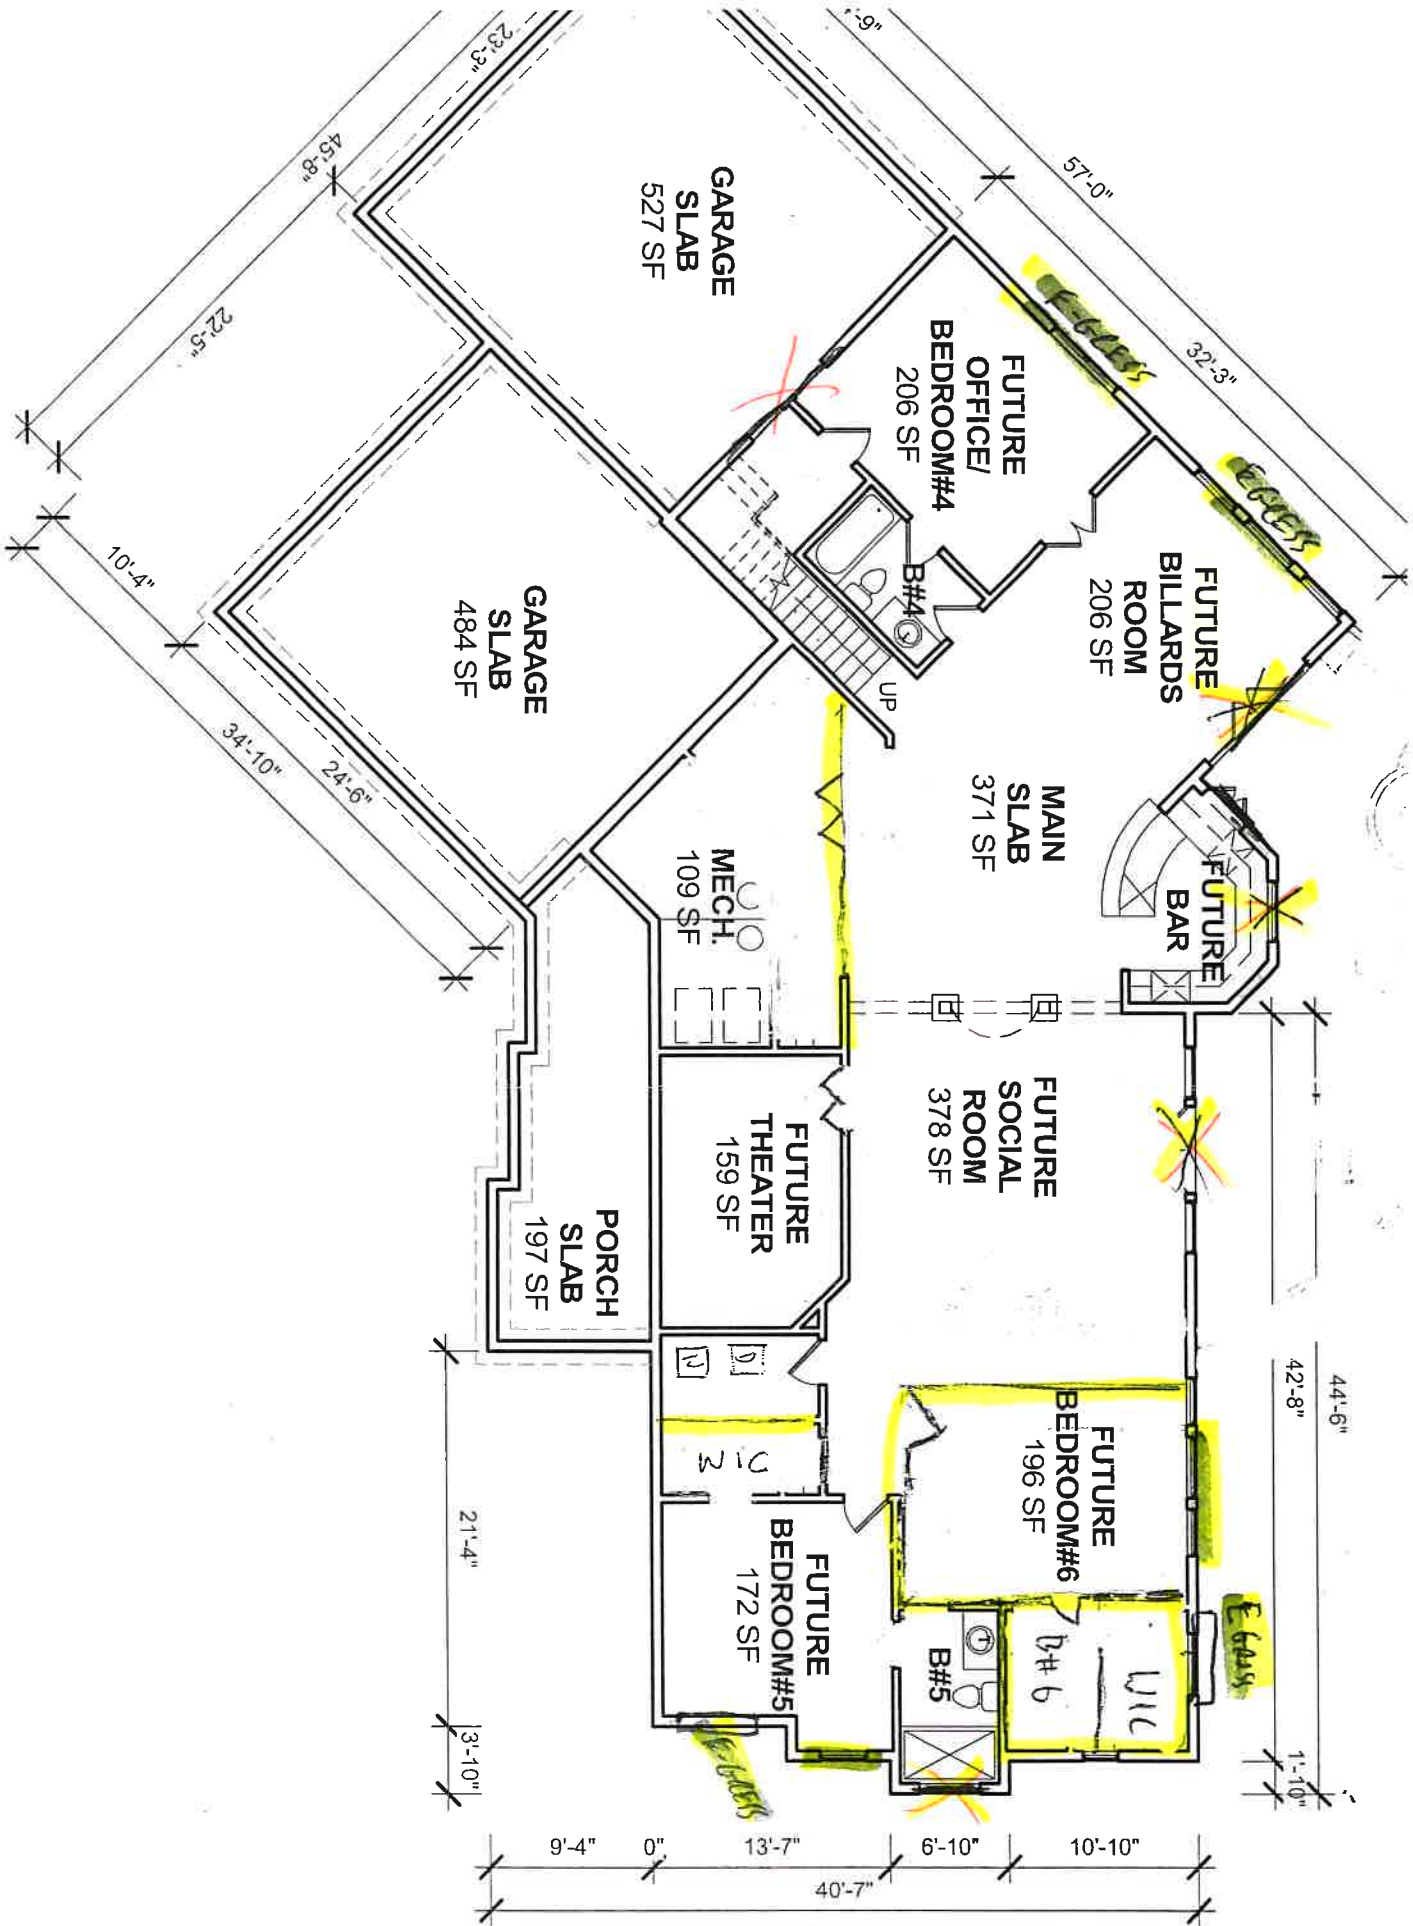

1 BASEMENT FLOOR PLAN
1" = 10'-0"